



FED. ROAD DIST. NO.	STATE	PROJECT NO.	COUNTY	CONTROL SECTION	STATE ROUTE	SHEET NO.	TOTAL SHEETS
7	NEVADA	102-1	CLARK	03-08		124	

Ref. Sheet IE-2

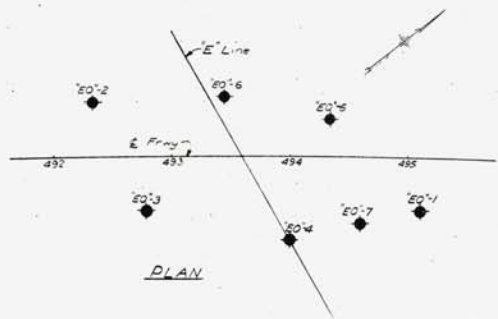

BM 84-
 "Top of 3" rebar E02 3 in. 20' & 4"
 2002 3 in. 20' rebar E01 20' 4"
 Elev. 2044.83

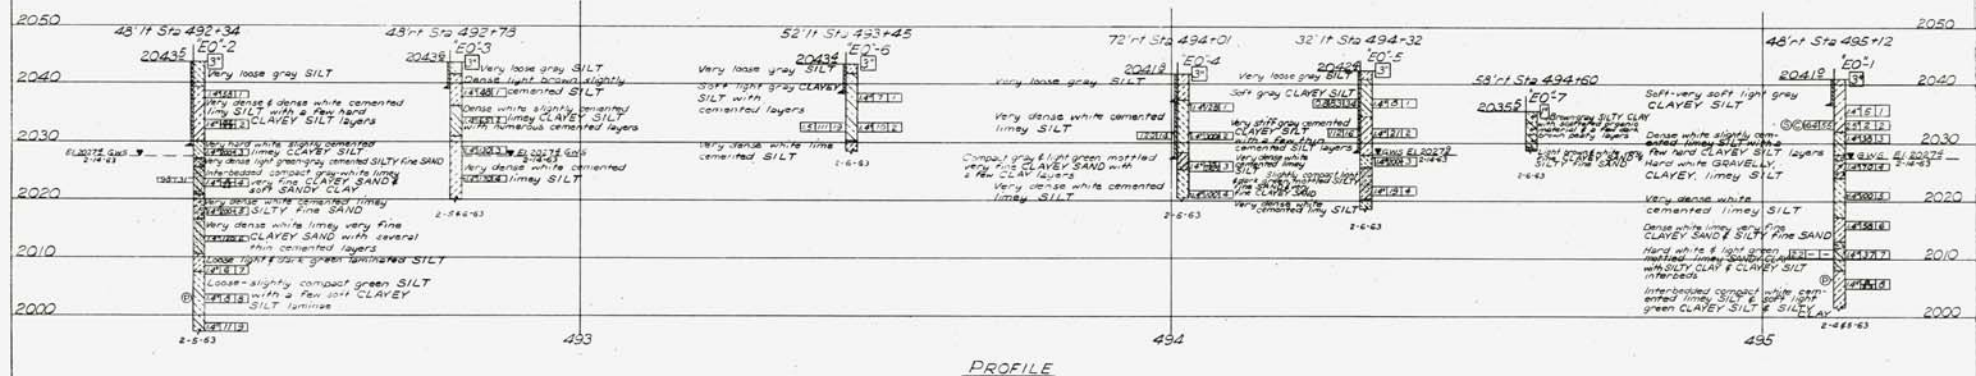

PROFILE

LEGEND OF EARTH MATERIALS

<p>SIZE CLASSIFICATION</p> <p>Diagram showing the best of general distribution used in representation of soil names. This classification is based on the A.S.T.M. classification in the A.S.T.M. grade scale in the laboratory. Use SYMBOLS.</p> <p>Classification of earth material when on the spot is based on field inspection and should not be continued to heavy mechanical analysis unless so stated.</p>	<p>MATERIAL SYMBOLS</p> <ul style="list-style-type: none"> Gravel Peat or organic matter Sand Silt Clay Silty clay or clayey silt Silty sand or sandy silt Sandstone Siltstone Limestone Metamorphic rock Igneous rock 	<p>CONSISTENCY CLASSIFICATION</p> <p>According to the Standard Penetration Test.</p> <table border="1"> <thead> <tr> <th>No. of blows</th> <th>Granular</th> <th>Cohesive</th> </tr> </thead> <tbody> <tr> <td>0-5</td> <td>very loose</td> <td>very soft</td> </tr> <tr> <td>6-10</td> <td>loose</td> <td>soft</td> </tr> <tr> <td>11-20</td> <td>slightly compact</td> <td>stiff</td> </tr> <tr> <td>21-35</td> <td>compact</td> <td>very stiff</td> </tr> <tr> <td>36-70</td> <td>dense</td> <td>hard</td> </tr> <tr> <td>70+</td> <td>very dense</td> <td>very hard</td> </tr> </tbody> </table>	No. of blows	Granular	Cohesive	0-5	very loose	very soft	6-10	loose	soft	11-20	slightly compact	stiff	21-35	compact	very stiff	36-70	dense	hard	70+	very dense	very hard
No. of blows	Granular	Cohesive																					
0-5	very loose	very soft																					
6-10	loose	soft																					
11-20	slightly compact	stiff																					
21-35	compact	very stiff																					
36-70	dense	hard																					
70+	very dense	very hard																					

LEGEND OF BORING OPERATIONS

<ul style="list-style-type: none"> Plan of any boring Flash penetrometer 2.5" Cone penetrometer Rotary boring Auger boring Sample boring Jet boring Diamond core boring Test pit 	<p>ROTARY BORING</p> <p>Location B-N.O.</p> <p>Top hole elev. _____</p> <p>Casing _____</p> <p>Sample No. _____</p> <p>Blows per foot (using a 140 lb. hammer with a 30" drop)</p> <p>Graphic representation of driving rate</p> <p>Date of boring _____</p>	<p>PENETRATION TEST</p> <p>Location B-N.O.</p> <p>Top hole elev. _____</p> <p>Blows per foot _____</p> <p>Date of boring _____</p>
--	---	---

MOORE AND TABER
 ENGINEERS - GEOLOGISTS

STATE OF NEVADA
 DEPARTMENT OF HIGHWAYS

LOG OF TEST BORINGS

DOWNTOWN EXPRESSWAY INTERCHANGE
 INTERSTATE OVER EXPRESSWAY
 I-937N & I-937S

DE LEUW, CATHAR & COMPANY
 ENGINEERS

SAN FRANCISCO, CALIFORNIA

DESIGNED BY _____
 DRAWN BY _____
 CHECKED BY _____
 APPROVED BY _____