



JOB NO.	DATE	PROJECT	CLIENT	CONTRACT	SHEET NO.	TOTAL SHEETS
7	10/10/61	104	ASH	83-083	51	

Ref. Sheet GA-2

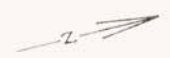

NOTE
 BM Lower Bull of 1/16 sec corner
 1321 21 ft north of Charleston on
 1/2 sec line 33
 Elev. 2043.21

NOTE
 BM Top of Bull of 1/4 sec corner
 8302 Lt. Sta. 439+53.1
 Elev. 2046.13

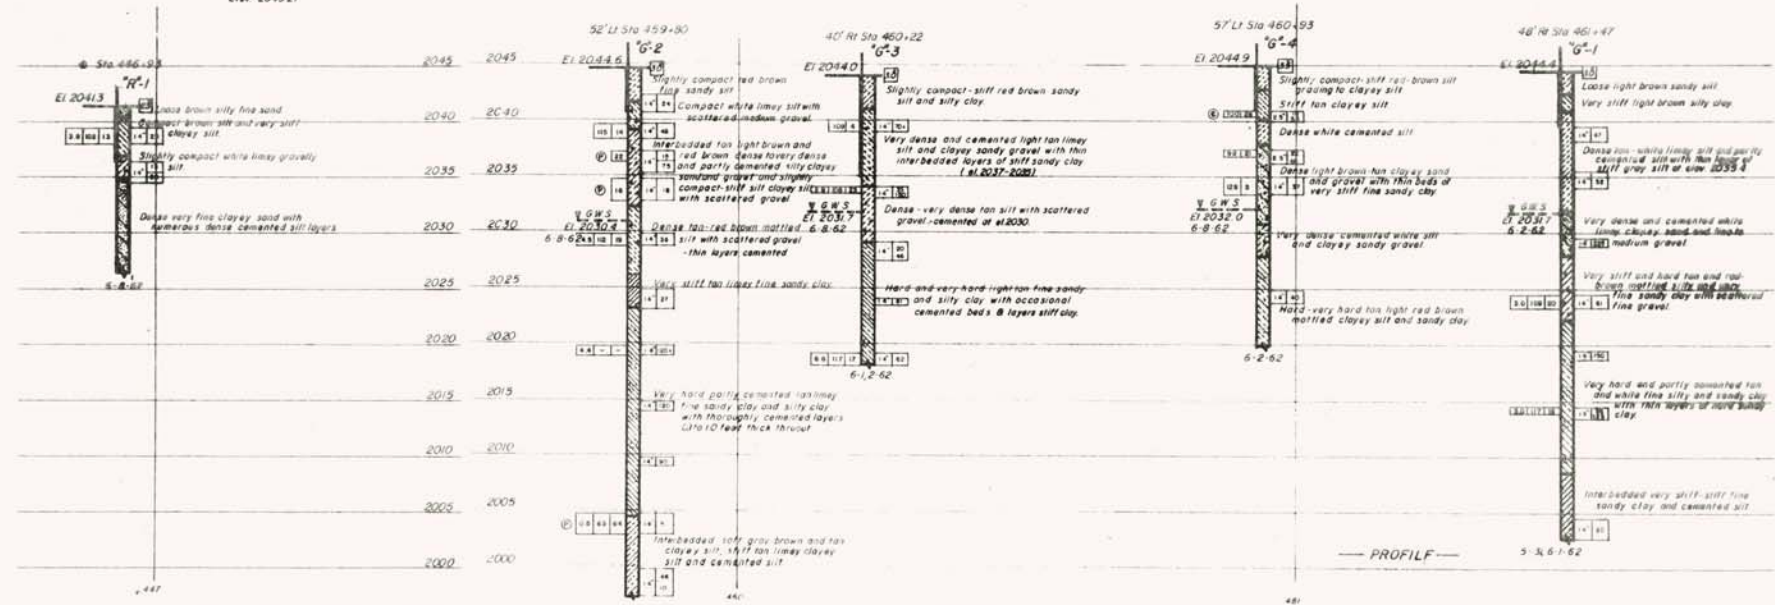

LEGEND OF EARTH MATERIALS

SIZE CLASSIFICATION	MATERIAL SYMBOLS	CONSISTENCY CLASSIFICATION
	Gravel	Allowing for Standard Penetration Test No. of Blows 0-5 Very loose 6-10 loose 11-20 slightly compact 21-30 compact 31-50 dense 51-70 very dense 70+ very hard
	Sand	
	Silt	
	Sandstone	
	Clay	
	Sandy clay or clayey sand	
	Sandy silt or silty sand	
	Silty clay or clayey silt	
	Shale	
	Limestone	
Marble or gneiss		
Granite		

LEGEND OF BORING OPERATIONS

ROTARY BORING	PENETRATION TEST

STATE OF NEVADA
 DEPARTMENT OF HIGHWAYS

GASS AVENUE OVERPASS
 R-935 N & H-935 S

LOG OF TEST BORINGS

MOORE and TABER
 Approved H.R. 10/10/61