
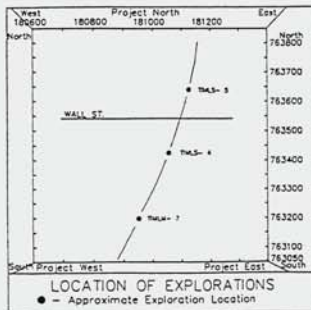


# FENCE DIAGRAM

FED. RD. REG. NO.	STATE	PROJECT NO.	COUNTY	SHEET NO.
9	NEVADA	DPC-009(002)	CLARK	B-71A

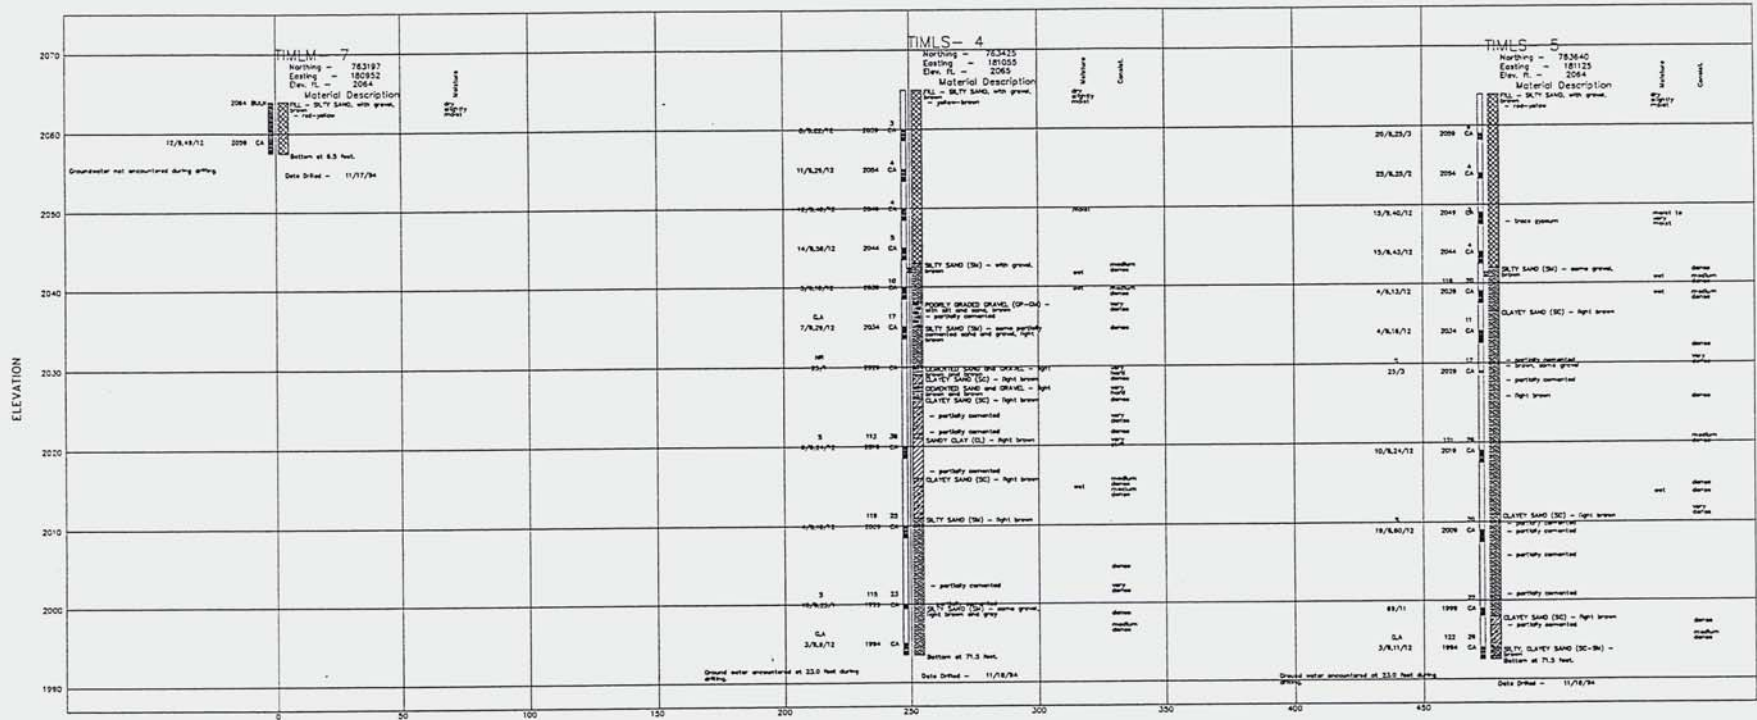

BEST FIT DISTANCE FROM FIRST BORING (ft.)

THESE BORING LOGS AND TEST SUMMARIES APPLY ONLY AT THE LOCATIONS DRILLED AND AT THE TIME OF EXPLORATION. CONDITIONS MAY DIFFER AT OTHER LOCATIONS AND MAY CHANGE AT THESE LOCATIONS WITH TIME. DATA IS A SIMPLIFICATION. SEE SHEET B-71B FOR FENCE DIAGRAM LEGEND.



ORIGINAL CONSTRUCTION CONTRACT NO 1195

STATE OF NEVADA  
DEPARTMENT OF TRANSPORTATION  
WALL STREET  
GRADE SEPARATION  
**LOG of BORINGS**

H-1042

	DESIGNED BY: MEV
	DRAWN BY: AJR
	CHECKED BY: MEV
	REVIEWED BY: AEM

PROJECT No. 31-215603

B-71A.DWG 8/75