



FED. ROAD DIST. NO.	STATE	PROJECT NO.	COUNTY	CONTROL SECTION	STATE ROUTE	SHEET NO.	TOTAL SHEETS
7	NEVADA	22	CLARK	83-023	NO	130	

Ref. Sheet OA-2

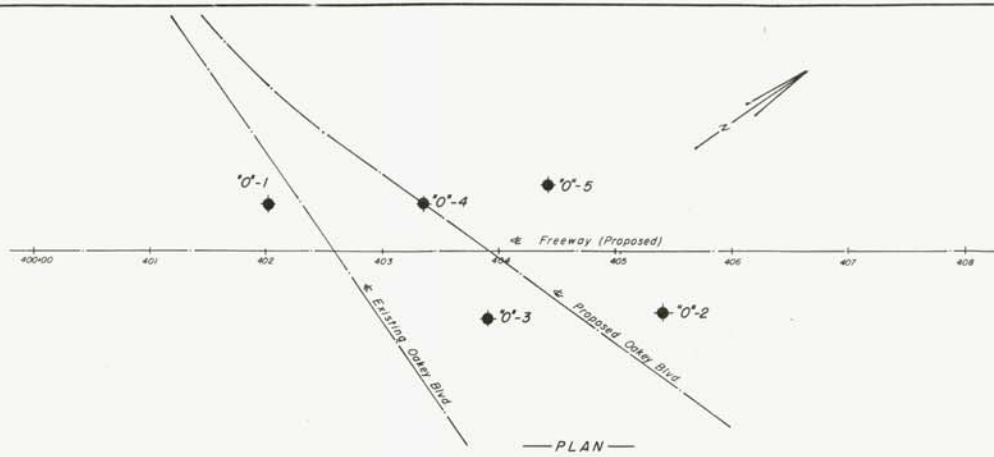


NOTE
 BM USC B G R P Oakley No. 1 1957
 Elevation 2048.750 (Field Survey)

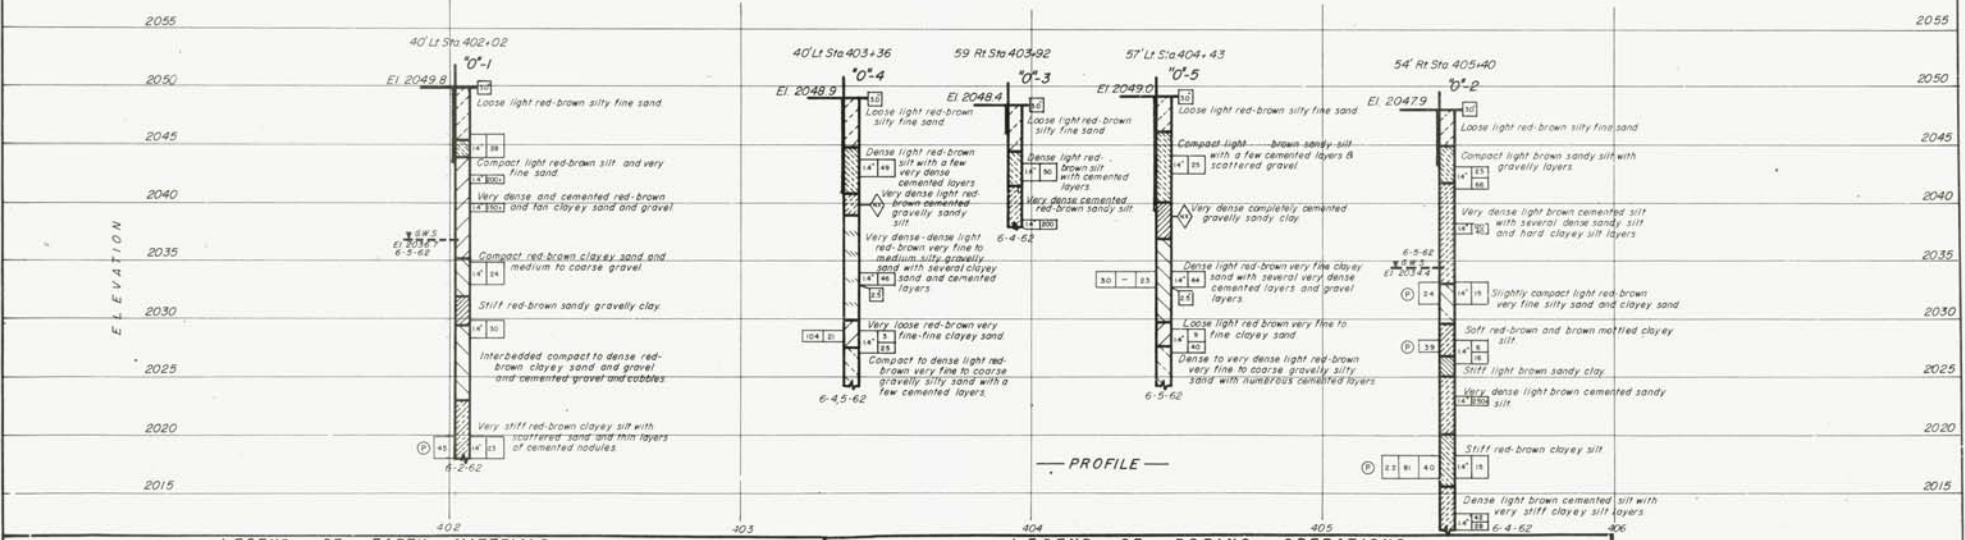

CONSISTENCY CLASSIFICATION

According to the Standard Penetration Test

No. of Blows	Granular	Cohesive
0-5	very loose	very soft
6-10	loose	soft
11-20	slightly compact	stiff
21-35	compact	very stiff
36-70	dense	hard
70+	very dense	very hard

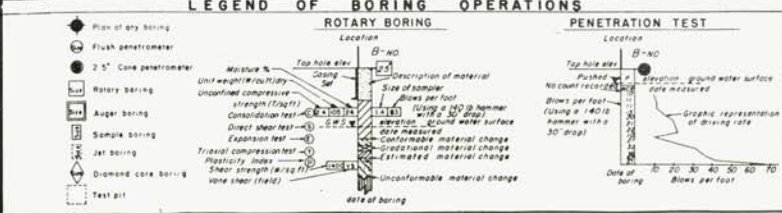

STATE OF NEVADA
 DEPARTMENT OF HIGHWAYS

OAKLEY BOULEVARD OVERPASS
 H-933N & H-933S

LOG OF TEST BORINGS

MOORE and TABER

Approved: *[Signature]* DATE: 3-22-55