
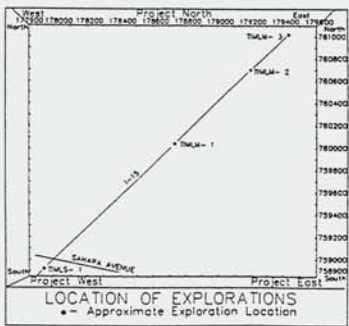


FENCE DIAGRAM

FED. RD. REG. NO.	STATE	PROJECT NO.	COUNTY	SHEET NO.
9	NEVADA	SP-015-(20)	CLARK	B-22A

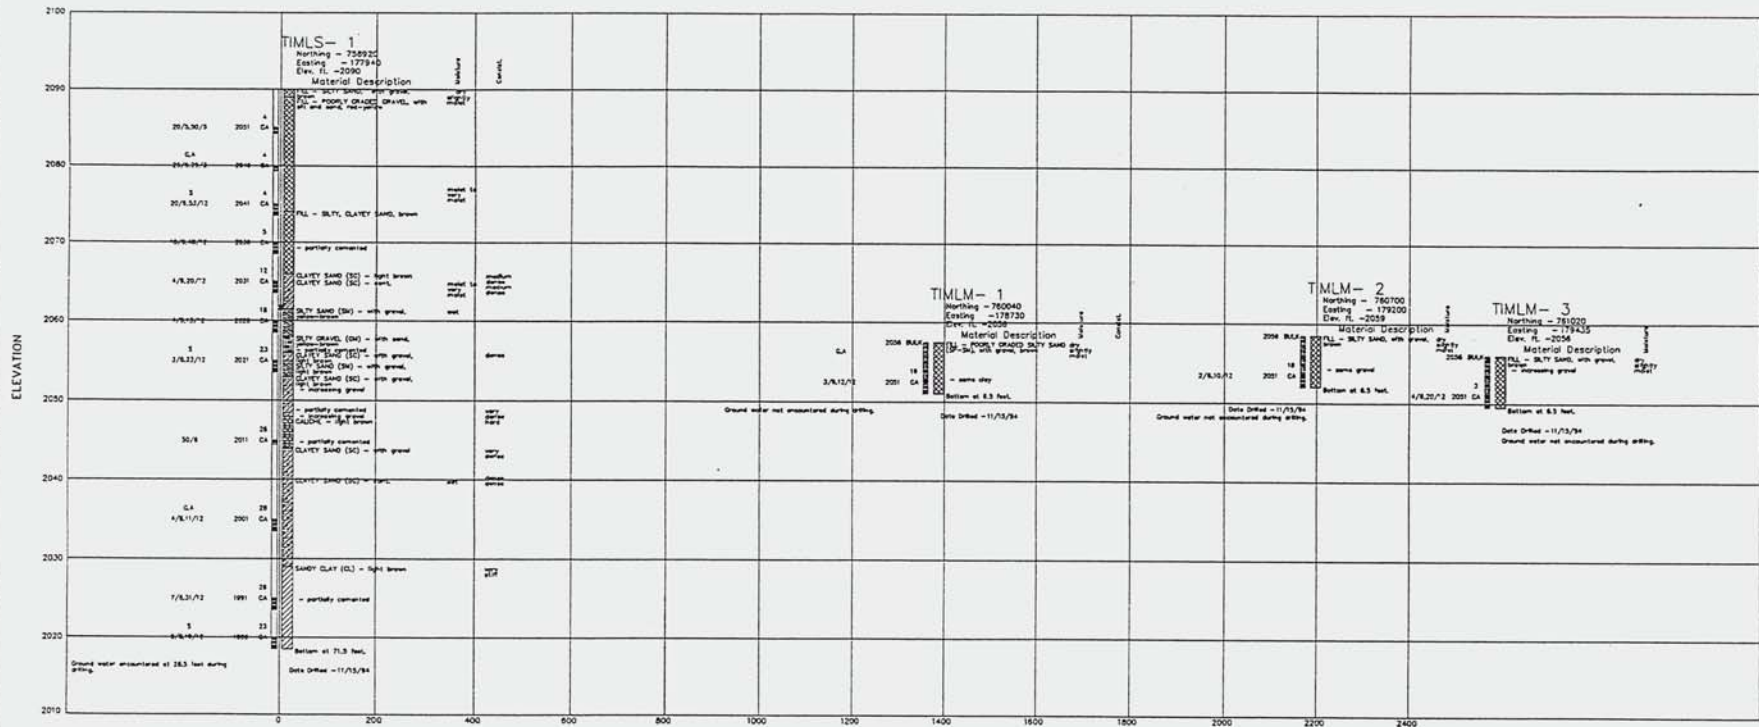

BEST FIT DISTANCE FROM FIRST BORING (ft.)

THESE BORING LOGS AND TEST SUMMARIES APPLY ONLY AT THE LOCATIONS DRILLED AND AT THE TIME OF EXPLORATION. CONDITIONS MAY DIFFER AT OTHER LOCATIONS AND MAY CHANGE AT THESE LOCATIONS WITH TIME. DATA IS A SIMPLIFICATION. SEE SHEET B-22B FOR FENCE DIAGRAM LEGEND.



ORIGINAL CONSTRUCTION CONTRACT NO 1172

STATE OF NEVADA
 DEPARTMENT OF TRANSPORTATION
 SAHARA AVENUE INTERCHANGE
LOG of BORINGS

1-837

	KLEINFELDER	DESIGNED BY: WEV
	Geotechnical and Environmental Engineers	DRAWN BY: AJR
	Sole and Material Testing	CHECKED BY: WEV
	PROJECT No. 31-21903	REVIEWED BY: AEM

B-22A.DWG. 8/75