


FENCE DIAGRAM

FED. RD. REG. NO.	STATE	PROJECT NO.	COUNTY	SHEET NO.
9	NEVADA	DPC-009(002)	CLARK	B1654

ELEVATION	TIMLS-12		TIMLS-13		TIMLS-14	
	Boring - 99270 Easting - 182205 Date - 2014	Material Description	Boring - 782208 Easting - 182205 Date - 2015	Material Description	Boring - 782202 Easting - 182205 Date - 2015	Material Description

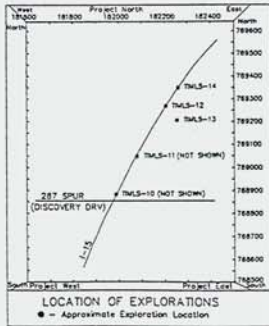

BEST FIT DISTANCE FROM FIRST BORING (11.)

THESE BORING LOGS AND TEST SUMMARIES APPLY ONLY AT THE LOCATIONS DRILLED AND AT THE TIME OF EXPLORATION. CONDITIONS MAY DIFFER AT OTHER LOCATIONS AND MAY CHANGE AT THESE LOCATIONS WITH TIME. DATA IS A SIMPLIFICATION. SEE SHEET B165B FOR FENCE DIAGRAM LEGEND.



ORIGINAL CONSTRUCTION CONTRACT NO 1259

STATE OF NEVADA
DEPARTMENT OF TRANSPORTATION
I-15 OVER RAMP E-N
GRADE SEPARATION
LOG of BORINGS

I-2138

DESIGNED BY: <u>SKV</u>
DRAWN BY: <u>ASB</u>
CHECKED BY: <u>BEV</u>
REVIEWED BY: <u>ARM</u>

PROJECT No. 31-215903

